

LEGEND

- 1. DN = DOWN
- 2. CLO = CLOSET
- 3. MECH = MECHANICAL
- 4. HW = HOT WATER
- 5. W/D = WASHER/DRYER
- 6. SF = SQUARE FEET

FOR REGISTRY USE ONLY


NOTES

- 1. ALL AREAS SHOWN ARE APPROXIMATE INTERIOR AREAS.
- 2. ALL MEASUREMENTS ARE TO THE INTERIOR FACE OF WALL STRUCTURE.

I, ANTHONY DIFRANCISCO, REGISTERED ARCHITECT, DO HEREBY CERTIFY THAT THIS PLAN FULLY AND ACCURATELY DEPICTS THE LAYOUT, LOCATION, UNIT NUMBER AND DIMENSIONS OF THE UNITS NUMBERED 1, 2, 3 AND 4 IN THE RUTLAND STREET CONDOMINIUM, AS BUILT PURSUANT TO MASSACHUSETTS GENERAL LAW CHAPTER 183A, AND FURTHER CERTIFY THAT THIS PLAN CONFORMS TO THE RULES AND REGULATIONS OF THE REGISTRY OF DEEDS.

ANTHONY DIFRANCISCO
ARCHITECT

DATE _____

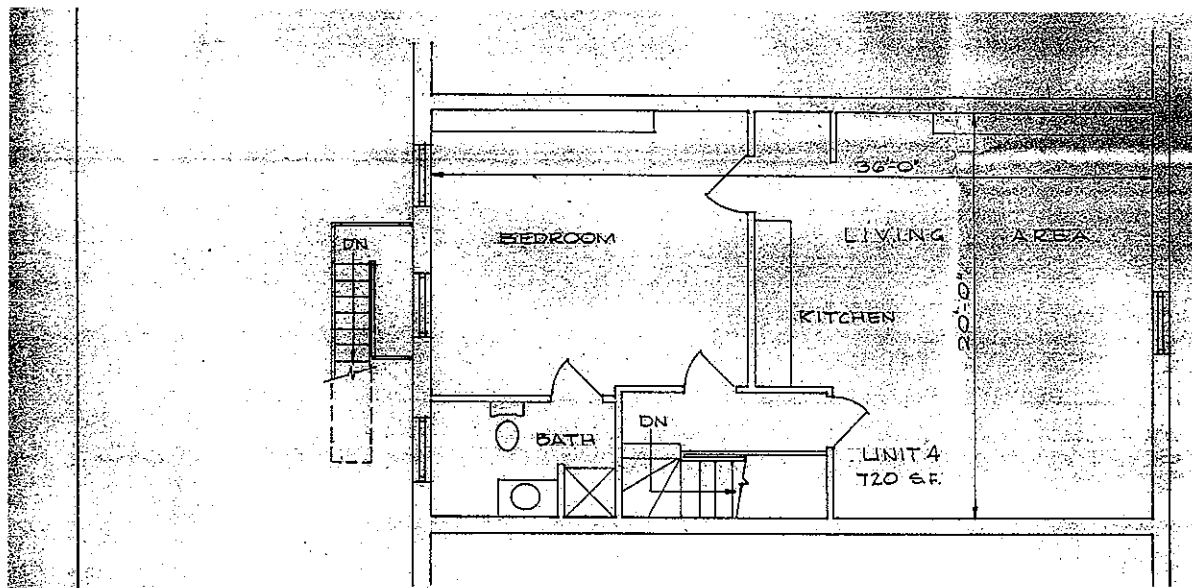

FOURTH FLOOR PLAN - UNIT 4 - TOTAL AREA = 720 SF
SCALE: 1/4" = 1'-0"



THE RUTLAND STREET 67 CONDOMINIUM
67 RUTLAND STREET
BOSTON, MASSACHUSETTS
ADE ARCHITECTS, INC.